

State of Alaska
Department of Fish and Game
Nomination for Waters
Important to Anadromous Species

~~85~~ 1986
Year of Revision

86-295

Approved

Name of Waterway Nielson Cr

AWC# of Waterway 111-⁴⁰~~80~~-10960

AWC Volume & Number SOUTHEAST REGION

USGS Quad 11 Juneau B-2 (11)

Addition ☒ Correction ☐
Deletion ☐ Change ☐

Change to ☒ Atlas
☒ Catalog
☐ Both

<u>Richard Reed</u> Regional Supervisor	<u>8/29/85</u> Date
<u>OK</u> <u>SPS</u>	<u>10/24/85</u>
<u>TPB</u> Drafted	<u>10/10/85</u> ALASKA DEPT. OF FISH & GAME

SEP - 3 1985

HABITAT
REGIONAL OFFICE

Add

Species	Date(s) Observed	Spawning	Rearing	Migration
Silver Salmon	Sept 7, 1984	✓	✓	

Comments: Provide any clarifying information, including number of fish observed, location of fish survey data, etc.


A coho juvenile was captured in a minnow trap above
the N. Douglas Hwy.

Attach a copy of a map showing location of mouth and upper points of each species, specific stream reaches identified for spawning or rearing, locations of barriers, such as falls. Attach a copy of the fish survey data, if available.

Name of Observer (please print) Kristen M Munk

Date: May 13, 1985 Signature: Kristen M Munk

Address: 3555-47 Mendenhall Lp Rd.
Juneau, AK 99801

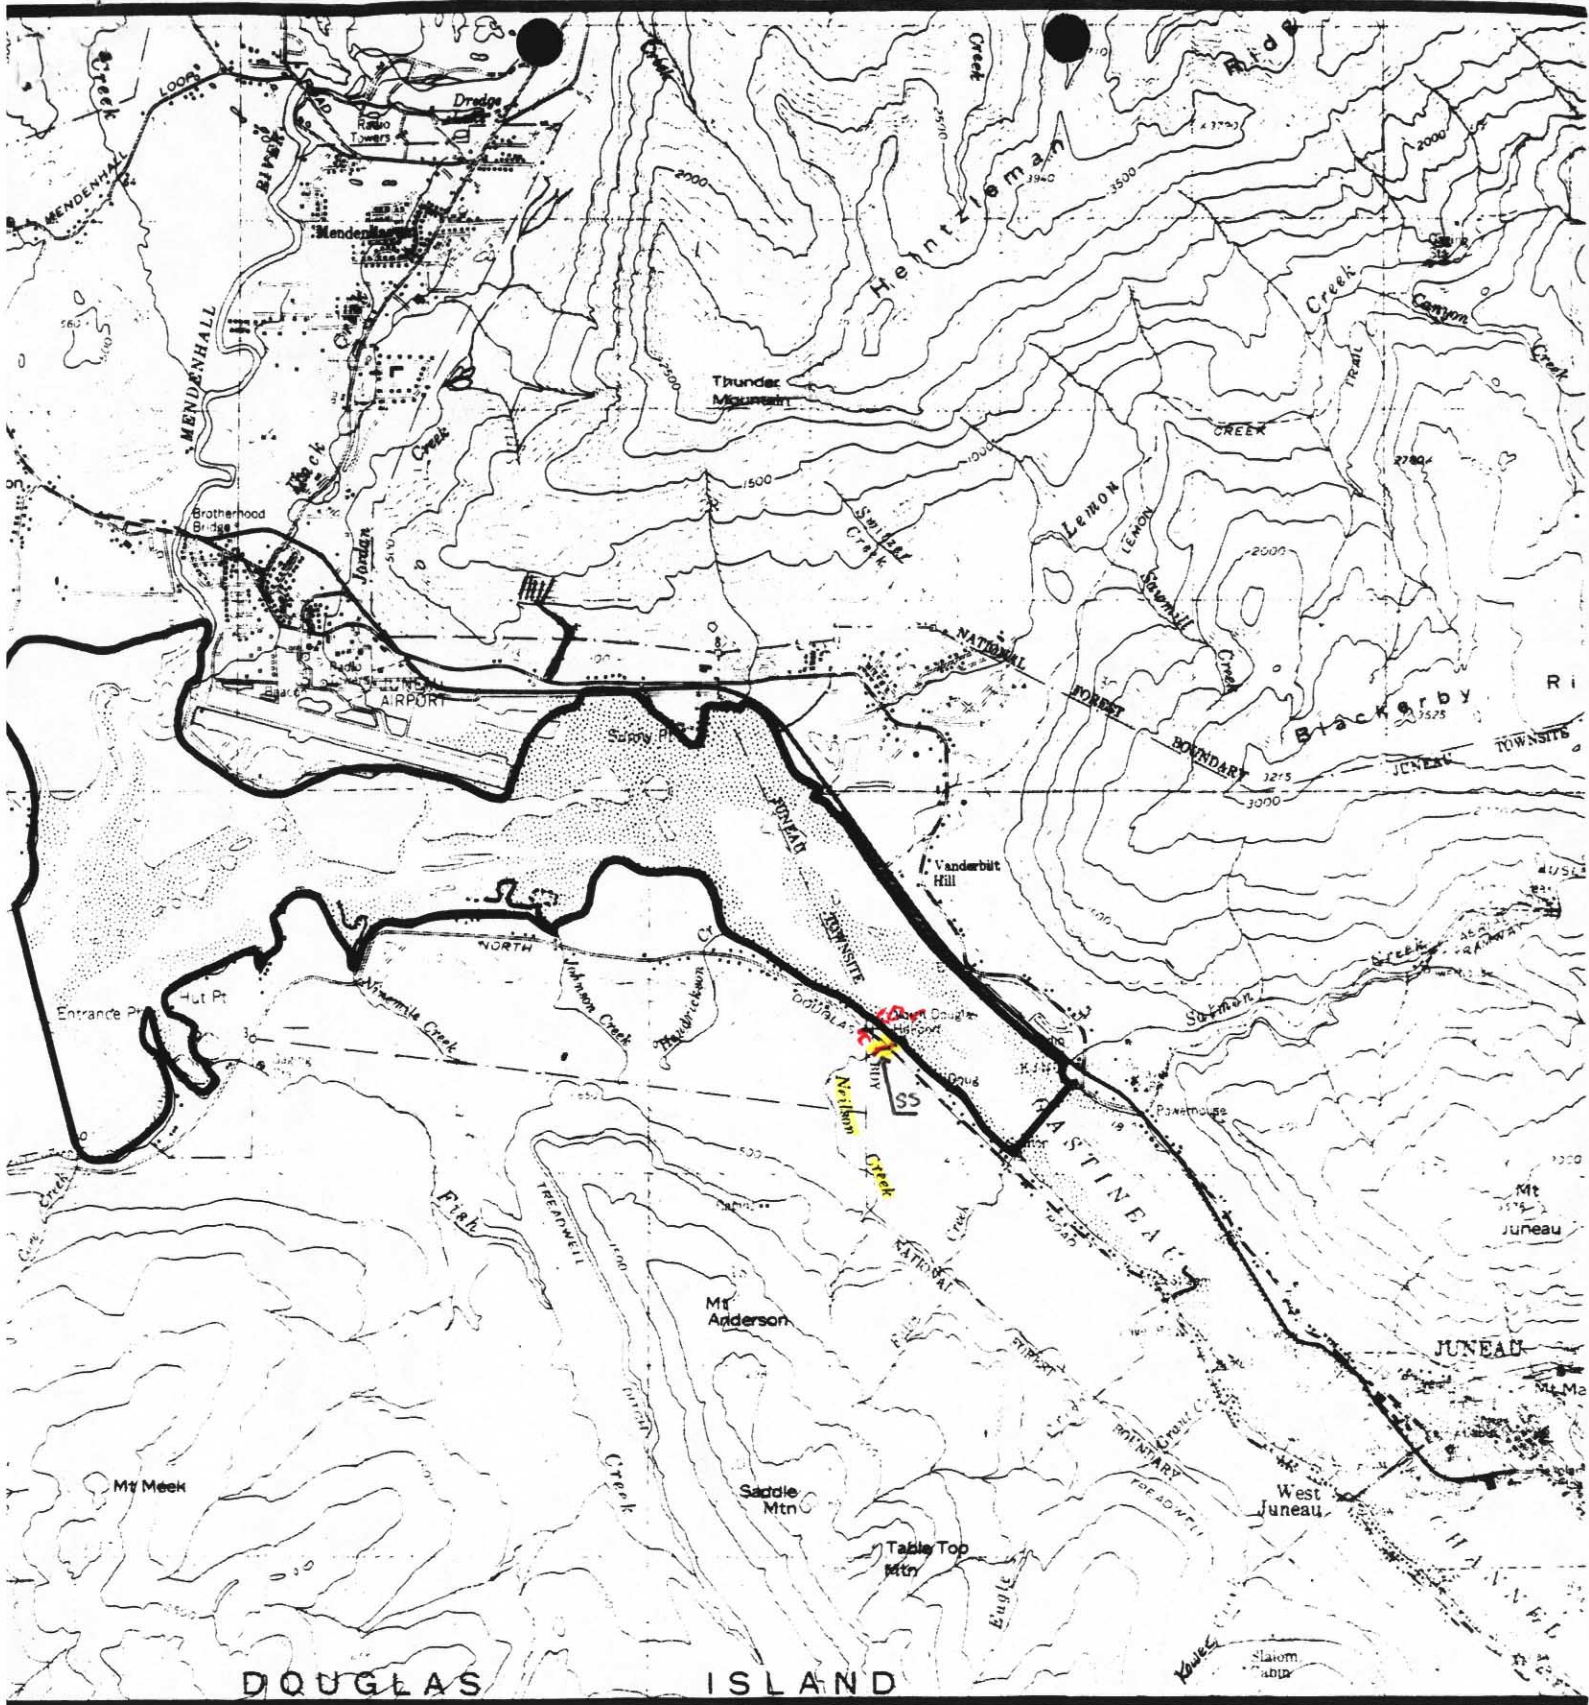

SCALE 1: 63,360

WETLANDS
Refuge

